

AS-BUILT DRAWING

60%

DRAWING No.	DESCRIPTION
UGU-2009-036-800-S-01	OVERALL LAYOUT
UGU-2009-036-800-S-02	LAYOUT AND LONGITUDINAL SECTION SHEET 1 OF 15
UGU-2009-036-800-S-03	LAYOUT AND LONGITUDINAL SECTION SHEET 2 OF 15
UGU-2009-036-800-S-04	LAYOUT AND LONGITUDINAL SECTION SHEET 3 OF 15
UGU-2009-036-800-S-05	LAYOUT AND LONGITUDINAL SECTION SHEET 4 OF 15
UGU-2009-036-800-S-06	LAYOUT AND LONGITUDINAL SECTION SHEET 5 OF 15
UGU-2009-036-800-S-07	LAYOUT AND LONGITUDINAL SECTION SHEET 6 OF 15
UGU-2009-036-800-S-08	LAYOUT AND LONGITUDINAL SECTION SHEET 7 OF 15
UGU-2009-036-800-S-09	LAYOUT AND LONGITUDINAL SECTION SHEET 8 OF 15
UGU-2009-036-800-S-10	LAYOUT AND LONGITUDINAL SECTION SHEET 9 OF 15
UGU-2009-036-800-S-11	LAYOUT AND LONGITUDINAL SECTION SHEET 10 OF 15
UGU-2009-036-800-S-12	LAYOUT AND LONGITUDINAL SECTION SHEET 11 OF 15
UGU-2009-036-800-S-13	LAYOUT AND LONGITUDINAL SECTION SHEET 12 OF 15
UGU-2009-036-800-S-14	LAYOUT AND LONGITUDINAL SECTION SHEET 13 OF 15
UGU-2009-036-800-S-15	LAYOUT AND LONGITUDINAL SECTION SHEET 14 OF 15
UGU-2009-036-800-S-16	LAYOUT AND LONGITUDINAL SECTION SHEET 15 OF 15
UGU-2009-036-800-S-17	LAYOUT AND LONG SECTION RISING MAIN SHEET 1 OF 2
UGU-2009-036-800-S-18	LAYOUT AND LONG SECTION RISING MAIN SHEET 2 OF 2

DATE	REVISIONS	INIT.
	INITIAL	SIGNATURE
DESIGNED		DESIGN ENGINEER
DRAWN		CAD TECHNICIAN
CHECKED		DESIGN ENGINEER
APPROVED		PROJECT ENGINEER

CLIENT


UGU DISTRICT MUNICIPALITY
P O Box 33
Port Shepstone
4240
Tel: 031 684 5841
Fax: 031 682 4568
95 Marine Drive
Oak Beach
Port Shepstone


PROJECT MANAGERS

P O Box 50079
Port Shepstone
4240
Tel: 031 684 0028
Fax: 031 684 0078
3 Umzinto Road
Oak Beach
Port Shepstone
4240
Email: mafaheni.co.za

PROJECT
UMZINTO SLUM CLEARANCE:
FARM ISONTI LOW COST HOUSING
SANITATION SCHEME - 500 UNITS

DRAWING TITLE
SHALLOW SEWER:
OVERALL LAYOUT

DRAWING No.	REVISION
UGU-2009-006-900-S-00	A
W-01	WATER DRAWINGS
STR-01	STRUCTURES DRAWINGS
S-01	SEWER DRAWINGS

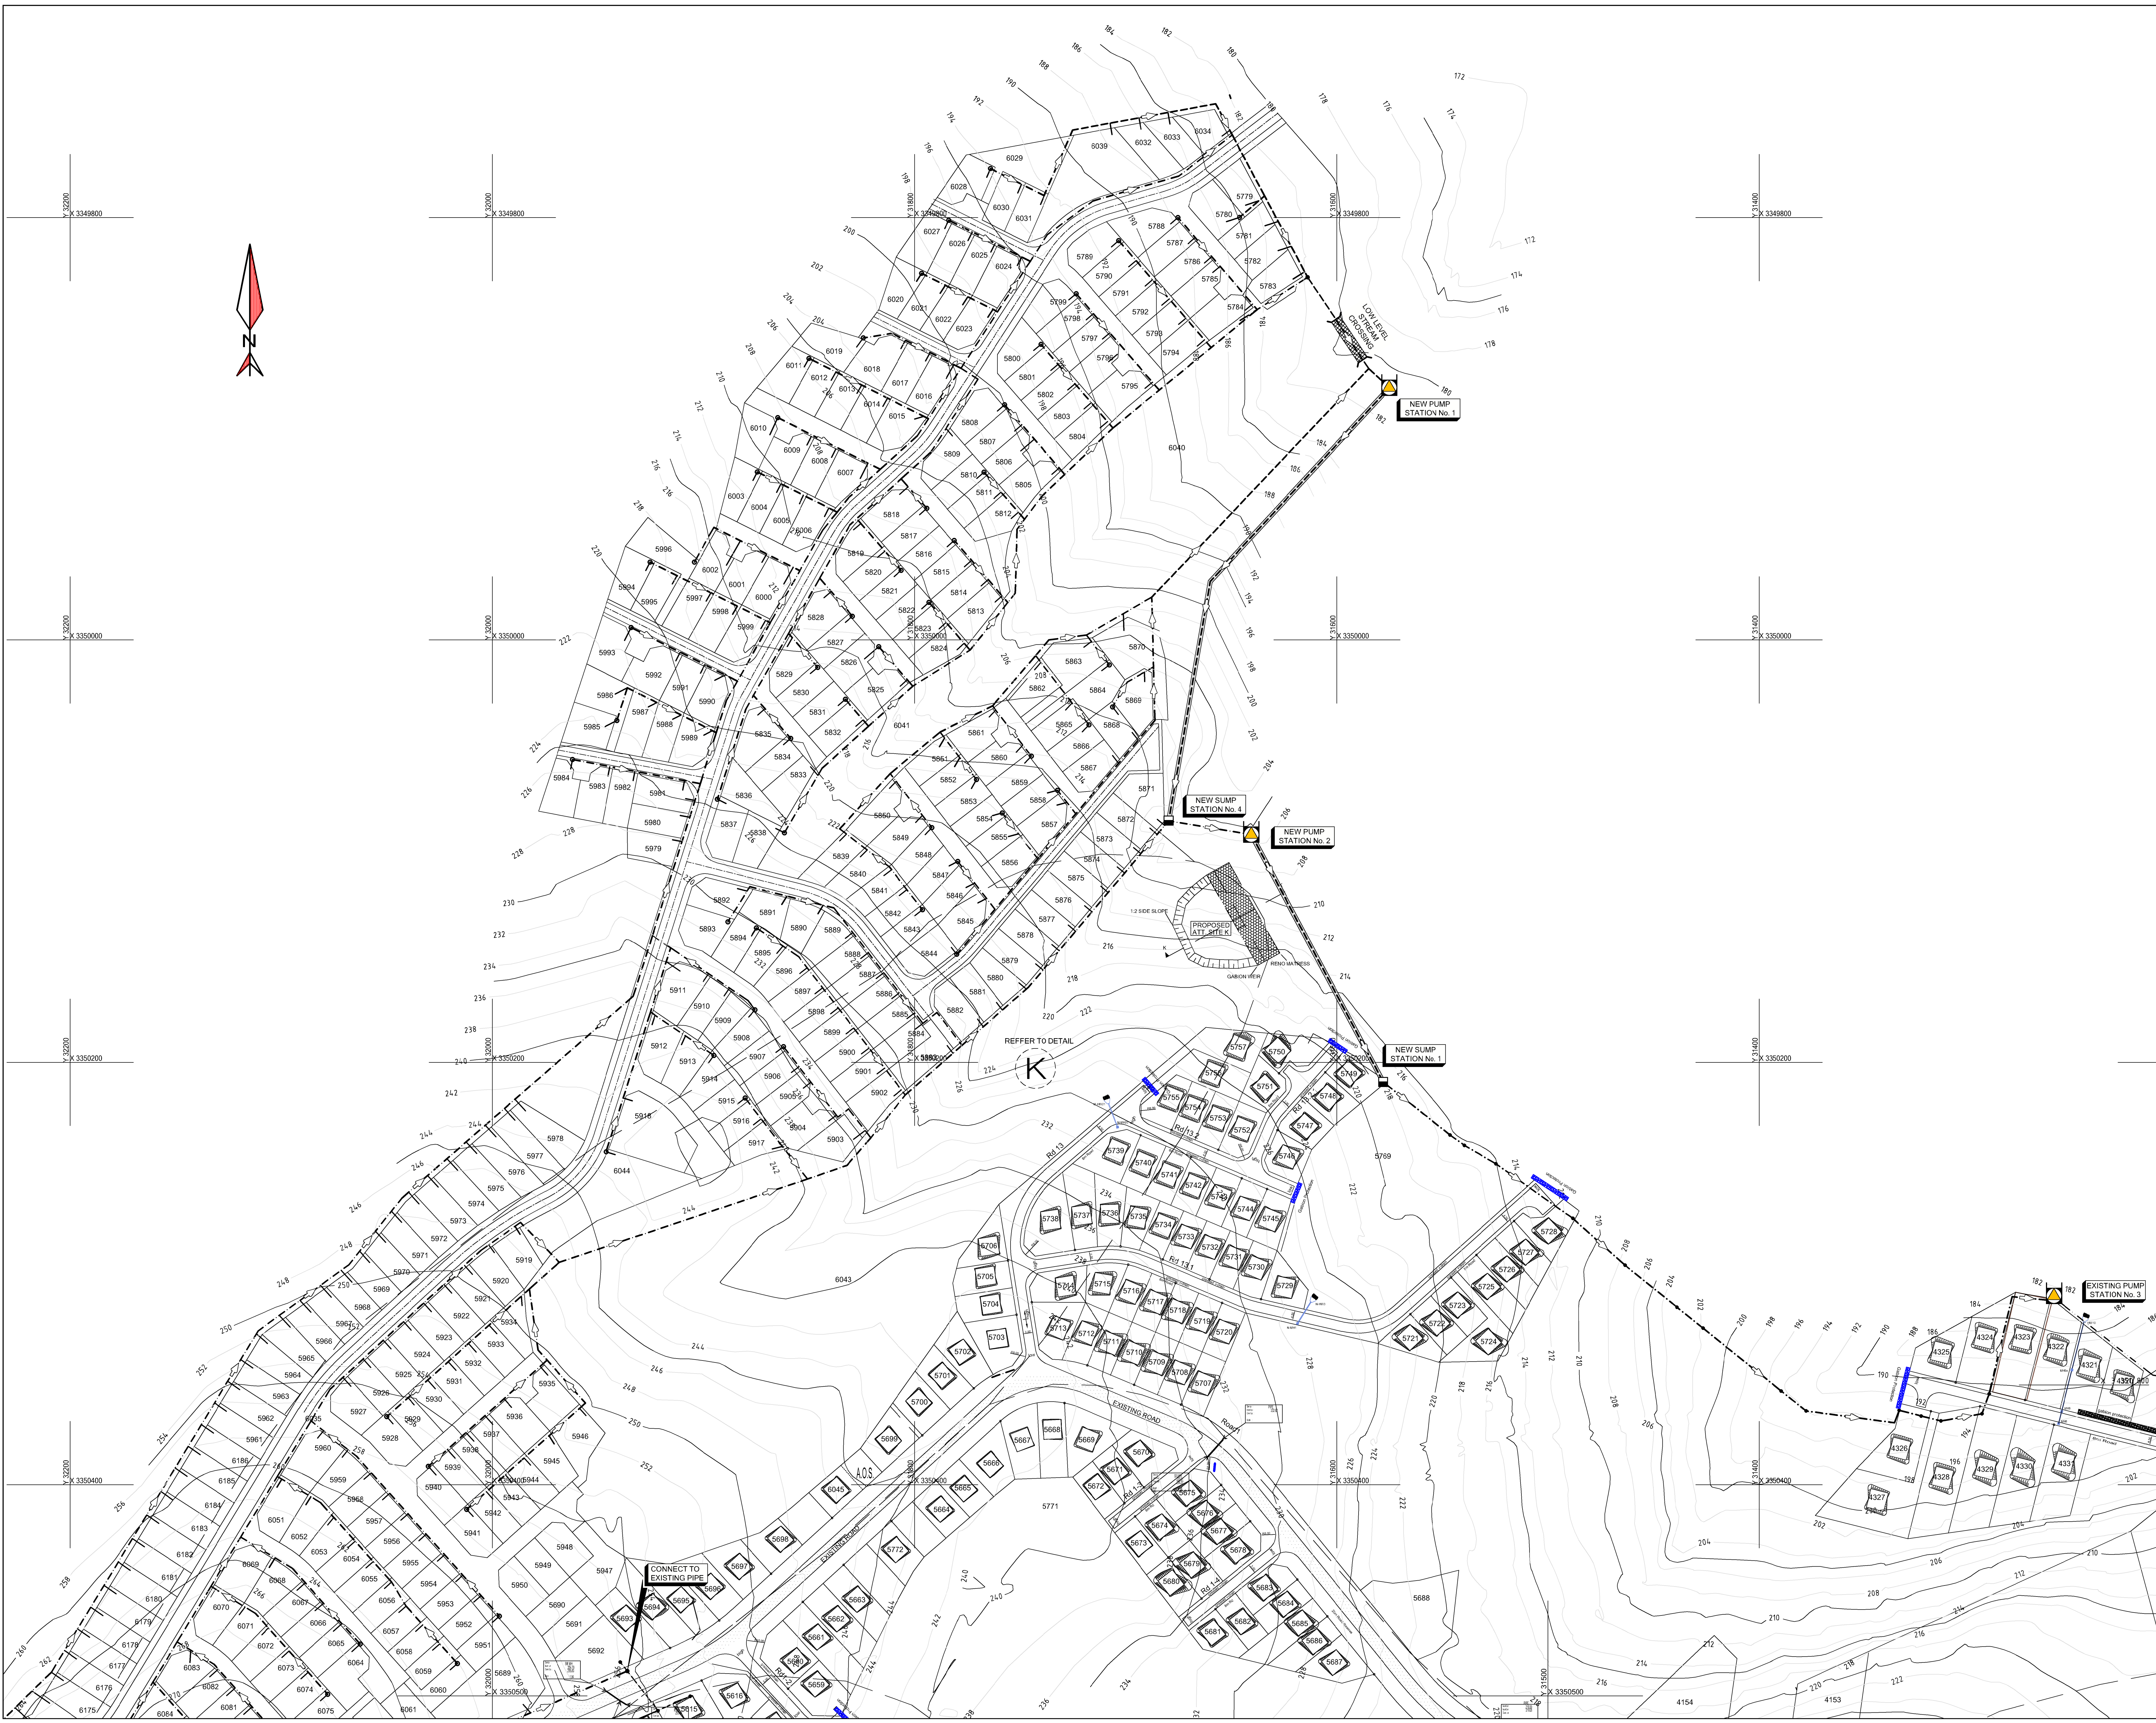

AS-BUILT DRAWING

DRAWING No.	DESCRIPTION
UGU-2009-036-800-S-01	OVERALL LAYOUT
UGU-2009-036-800-S-02	LAYOUT AND LONGITUDINAL SECTION SHEET 1 OF 15
UGU-2009-036-800-S-03	LAYOUT AND LONGITUDINAL SECTION SHEET 2 OF 15
UGU-2009-036-800-S-04	LAYOUT AND LONGITUDINAL SECTION SHEET 3 OF 15
UGU-2009-036-800-S-05	LAYOUT AND LONGITUDINAL SECTION SHEET 4 OF 15
UGU-2009-036-800-S-06	LAYOUT AND LONGITUDINAL SECTION SHEET 5 OF 15
UGU-2009-036-800-S-07	LAYOUT AND LONGITUDINAL SECTION SHEET 6 OF 15
UGU-2009-036-800-S-08	LAYOUT AND LONGITUDINAL SECTION SHEET 7 OF 15
UGU-2009-036-800-S-09	LAYOUT AND LONGITUDINAL SECTION SHEET 8 OF 15
UGU-2009-036-800-S-10	LAYOUT AND LONGITUDINAL SECTION SHEET 9 OF 15
UGU-2009-036-800-S-11	LAYOUT AND LONGITUDINAL SECTION SHEET 10 OF 15
UGU-2009-036-800-S-12	LAYOUT AND LONGITUDINAL SECTION SHEET 11 OF 15
UGU-2009-036-800-S-13	LAYOUT AND LONGITUDINAL SECTION SHEET 12 OF 15
UGU-2009-036-800-S-14	LAYOUT AND LONGITUDINAL SECTION SHEET 13 OF 15
UGU-2009-036-800-S-15	LAYOUT AND LONGITUDINAL SECTION SHEET 14 OF 15
UGU-2009-036-800-S-16	LAYOUT AND LONGITUDINAL SECTION SHEET 15 OF 15
UGU-2009-036-800-S-17	LAYOUT AND LONG SECTION RISING MAIN SHEET 1 OF 2
UGU-2009-036-800-S-18	LAYOUT AND LONG SECTION RISING MAIN SHEET 2 OF 2

DATE	REVISIONS	INIT.

	INITIAL	SIGNATURE	DESIGNATION
DESIGNED			DESIGN ENGINEER
DRAWN			CAD TECHNICIAN
CHECKED			DESIGN ENGINEER
APPROVED			PROJECT ENGINEER

CLIENT



UGU DISTRICT MUNICIPALITY

P O Box 33
Port Shepstone
4240
Tel: 031 684 0028
Fax: 031 682 4598

96 Marine Drive
Ox-Bow
Port Shepstone



PROJECT MANAGERS

P O Box 5078
Port Shepstone
4240
Tel: 031 684 0028
Fax: 031 684 0078

3 Umfolosi Road
Ox-Bow
Port Shepstone
Tel: 031 684 0028
Fax: 031 682 4598

PROJECT

UMZINTO SLUM CLEARANCE:
FARM ISONTI LOW COST HOUSING
SANITATION SCHEME - 500 UNITS

DRAWING TITLE

SHALLOW SEWER:
OVERALL LAYOUT

DRAWING No.

UGU-2009-036-900-S-01

REVISION

A

W-01 WATER DRAWINGS

STR-01 STRUCTURES DRAWINGS

S-01 SEWER DRAWINGS



AS-BUILT DRAWING

DRAWING No.

UGU-2009-036-800-S-01

DESCRIPTION

OVERALL LAYOUT
LAYOUT AND LONGITUDINAL
SECTION SHEET 1 OF 15
LAYOUT AND LONGITUDINAL
SECTION SHEET 2 OF 15
LAYOUT AND LONGITUDINAL
SECTION SHEET 3 OF 15
LAYOUT AND LONGITUDINAL
SECTION SHEET 4 OF 15
LAYOUT AND LONGITUDINAL
SECTION SHEET 5 OF 15
LAYOUT AND LONGITUDINAL
SECTION SHEET 6 OF 15
LAYOUT AND LONGITUDINAL
SECTION SHEET 7 OF 15
LAYOUT AND LONGITUDINAL
SECTION SHEET 8 OF 15
LAYOUT AND LONGITUDINAL
SECTION SHEET 9 OF 15
LAYOUT AND LONGITUDINAL
SECTION SHEET 10 OF 15
LAYOUT AND LONGITUDINAL
SECTION SHEET 11 OF 15
LAYOUT AND LONGITUDINAL
SECTION SHEET 12 OF 15
LAYOUT AND LONGITUDINAL
SECTION SHEET 13 OF 15
LAYOUT AND LONGITUDINAL
SECTION SHEET 14 OF 15
LAYOUT AND LONGITUDINAL
SECTION SHEET 15 OF 15
LAYOUT AND LONG SECTION
RISING MAIN SHEET 1 OF 2
LAYOUT AND LONG SECTION
RISING MAIN SHEET 2 OF 2

DATE

REVISIONS

INIT.

DESIGNED

INITIAL

SIGNATURE

DESIGNATION

DRAWN

CAD TECHNICIAN

CHECKED

DESIGN ENGINEER

APPROVED

PROJECT ENGINEER

CLIENT

UGU DISTRICT MUNICIPALITY

P O Box 33
Port Shepstone
4240
Tel: 031 684 0028
Fax: 031 684 0078

96 Marine Drive
Ox-Bow
Port Shepstone
Tel: 031 684 0041
Fax: 031 684 4598

PROJECT MANAGERS

PORT SHEPSTONE

UGU DISTRICT MUNICIPALITY

UGU DISTRICT MUNICIPALITY

P O Box 5007
Port Shepstone
4240
Tel: 031 684 0028
Fax: 031 684 0078

3 Umfolosi Road
Ox-Bow
Port Shepstone
Tel: 031 684 0041
Fax: 031 684 4598

PROJECT

UMJINTO SLUM CLEARANCE:
FARM ISONTI LOW COST HOUSING
SANITATION SCHEME - 500 UNITS

DRAWING TITLE

SHALLOW SEWER:
OVERALL LAYOUT

DRAWING No.

UGU-2009-006-900-S-03

REVISION

A

W-01


WATER DRAWINGS

STR-01

STRUCTURES DRAWINGS

S-01

SEWER DRAWINGS

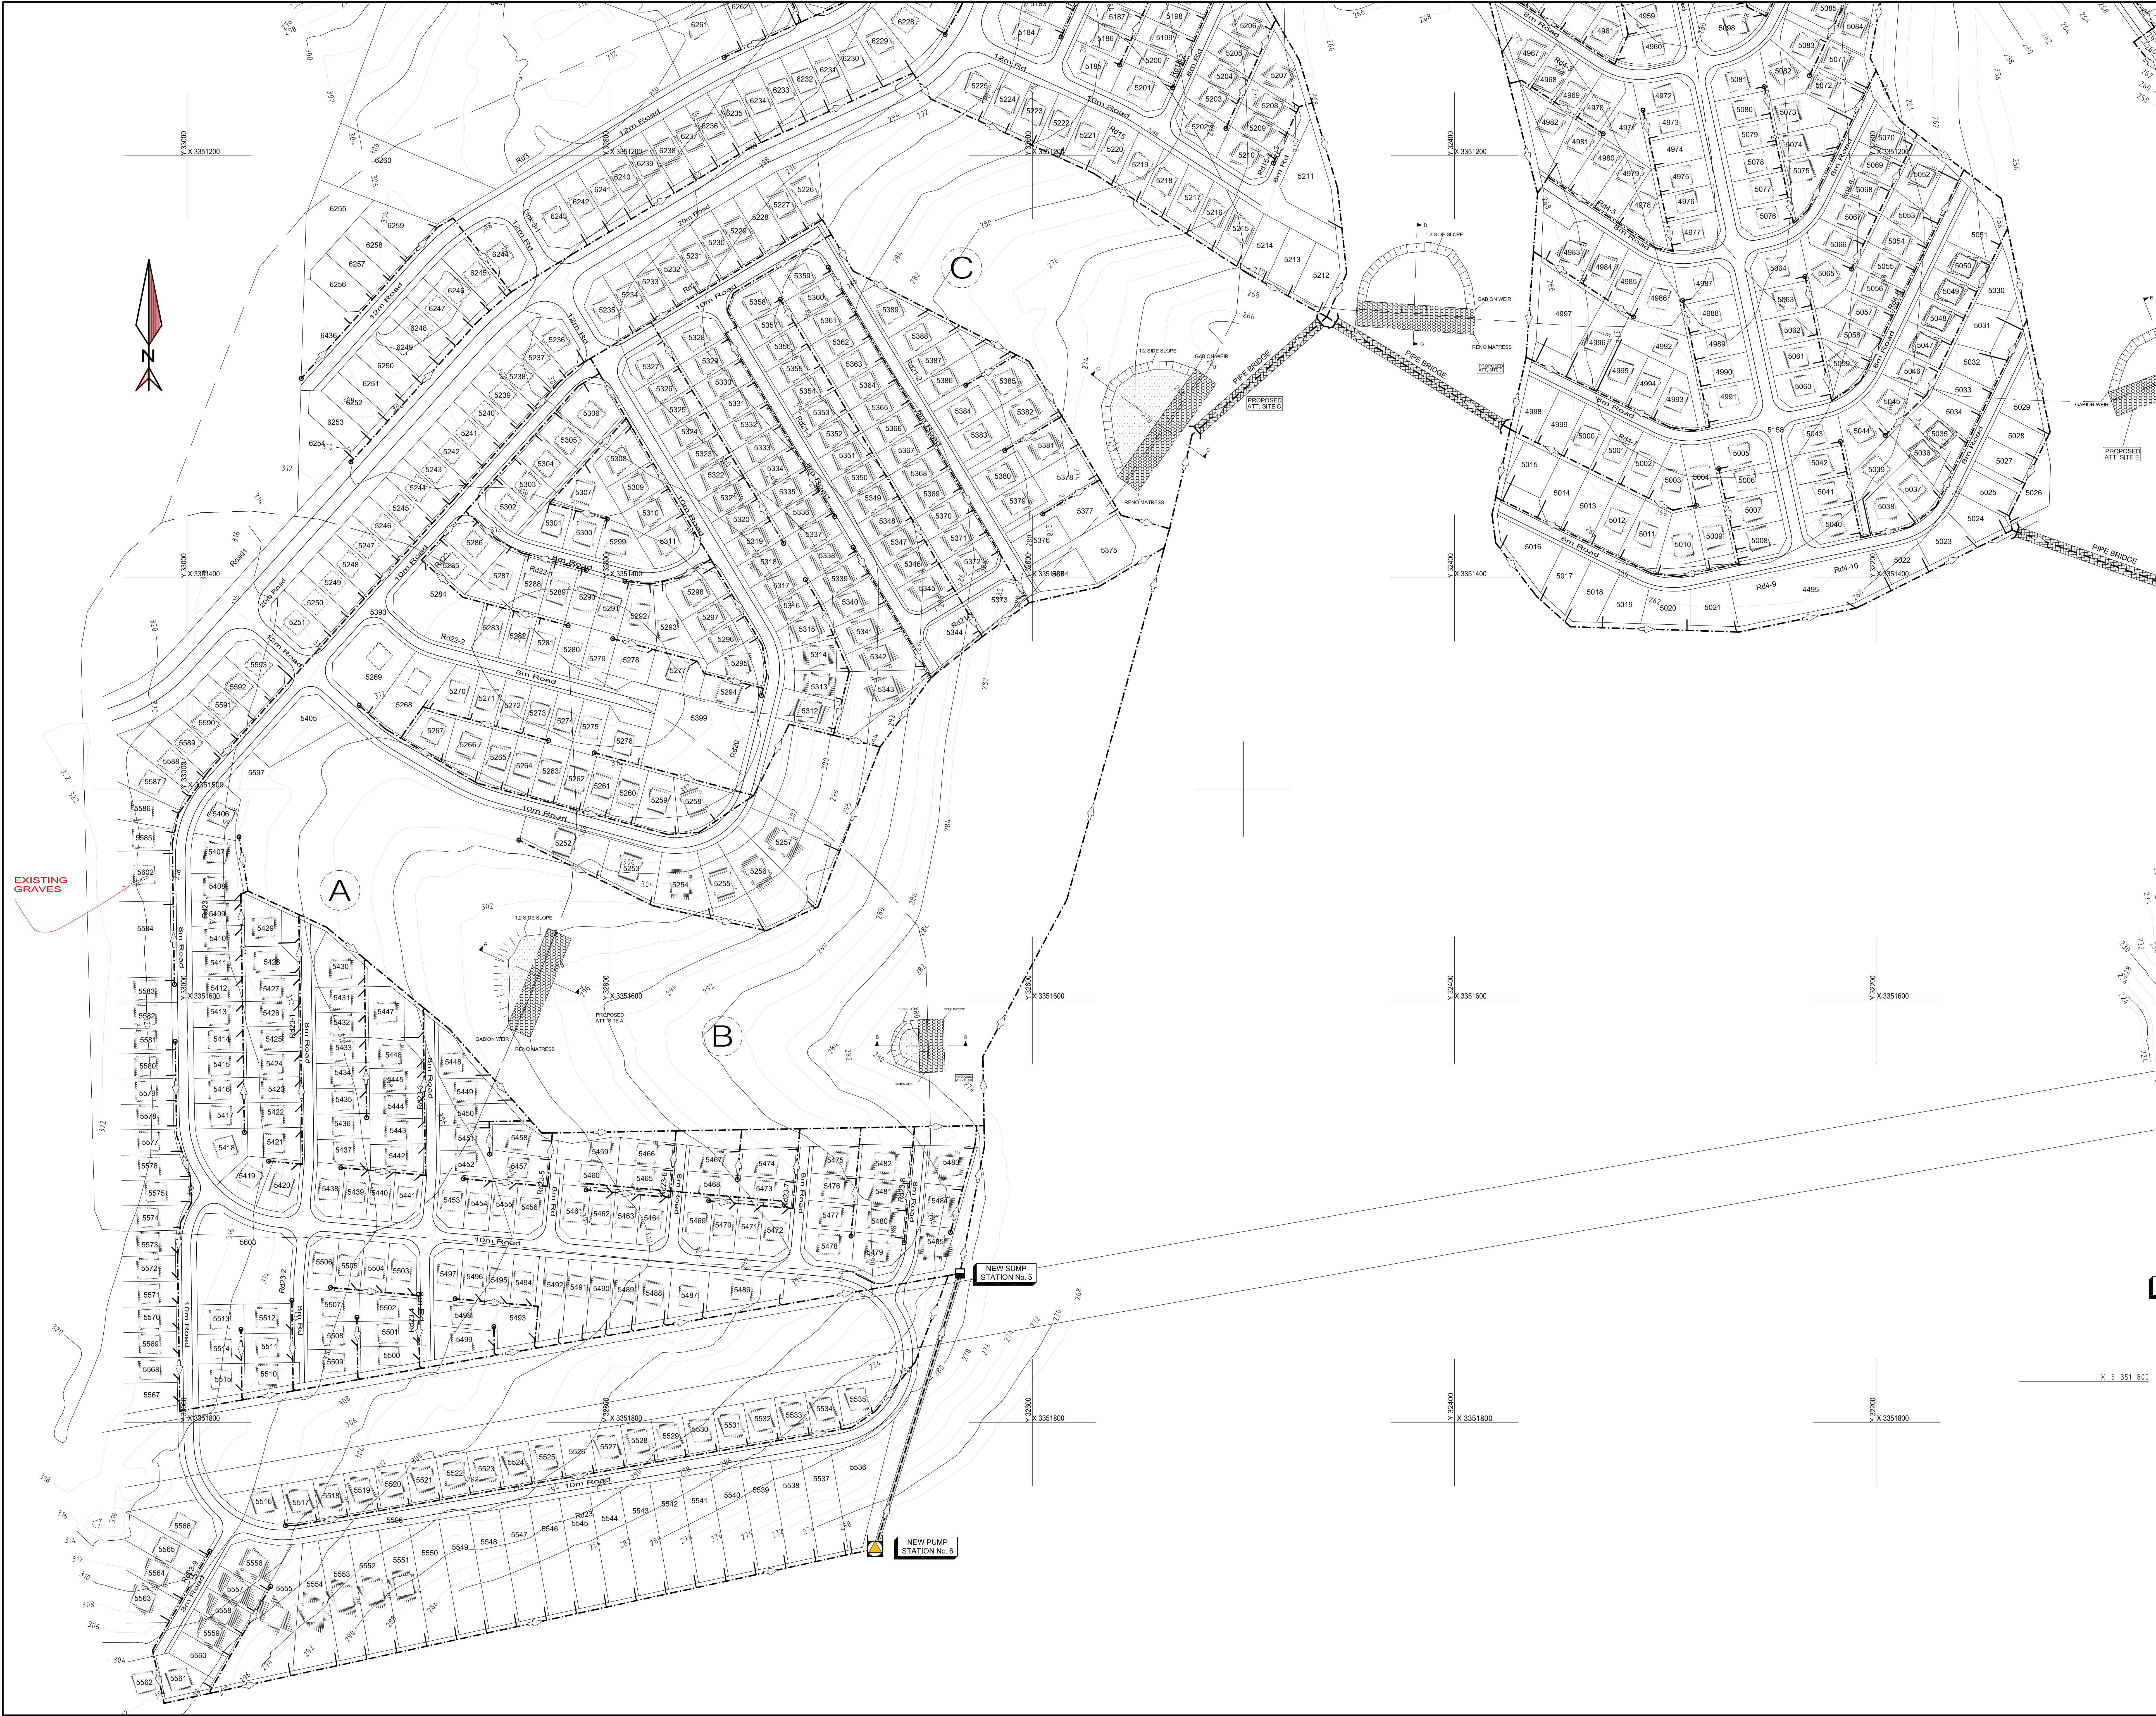

AS-BUILT DRAWING

DRAWING No.
UGU-2009-006-800-S-01

UGU-2009-006-800-S-02

UGU-2009-006-800-S-03

UGU-2009-006-800-S-04

UGU-2009-006-800-S-05

UGU-2009-006-800-S-06

UGU-2009-006-800-S-07

UGU-2009-006-800-S-08

UGU-2009-006-800-S-09

UGU-2009-006-800-S-10

UGU-2009-006-800-S-11

UGU-2009-006-800-S-12

UGU-2009-006-800-S-13

UGU-2009-006-800-S-14

UGU-2009-006-800-S-15

UGU-2009-006-800-S-16

UGU-2009-006-800-S-17

UGU-2009-006-800-S-18

OVERALL LAYOUT
LAYOUT AND LONGITUDINAL
SECTION SHEET 1 OF 15
LAYOUT AND LONGITUDINAL
SECTION SHEET 2 OF 15
LAYOUT AND LONGITUDINAL
SECTION SHEET 3 OF 15
LAYOUT AND LONGITUDINAL
SECTION SHEET 4 OF 15
LAYOUT AND LONGITUDINAL
SECTION SHEET 5 OF 15
LAYOUT AND LONGITUDINAL
SECTION SHEET 6 OF 15
LAYOUT AND LONGITUDINAL
SECTION SHEET 7 OF 15
LAYOUT AND LONGITUDINAL
SECTION SHEET 8 OF 15
LAYOUT AND LONGITUDINAL
SECTION SHEET 9 OF 15
LAYOUT AND LONGITUDINAL
SECTION SHEET 10 OF 15
LAYOUT AND LONGITUDINAL
SECTION SHEET 11 OF 15
LAYOUT AND LONGITUDINAL
SECTION SHEET 12 OF 15
LAYOUT AND LONGITUDINAL
SECTION SHEET 13 OF 15
LAYOUT AND LONGITUDINAL
SECTION SHEET 14 OF 15
LAYOUT AND LONG SECTION
RISING MAIN SHEET 1 OF 2
RISING MAIN SHEET 2 OF 2

DATE	REVISIONS	INIT.

	INITIAL	SIGNATURE	DESIGNATION
DESIGNED			DESIGN ENGINEER
DRAWN			CAD TECHNICIAN
CHECKED			DESIGN ENGINEER
APPROVED			PROJECT ENGINEER

CLIENT

UGU DISTRICT MUNICIPALITY
P O Box 33
Port Shepstone
4240
Tel: 039 688 0841
Fax: 039 682 4098

96 Marine Drive
Oxley Beach
Port Shepstone

PROJECT MANAGERS

Mafatlani Engineering & Construction
P O Box 50079
Port Shepstone
4240
Tel: 039 684 0028
Fax: 039 684 0078

3 Umdoni Road
Oxley Beach
Port Shepstone
4240
Tel: 039 684 0028
Fax: 039 684 0078

PROJECT

UMZINTO SLUM CLEARANCE:
FARM ISONTI LOW COST HOUSING
SANITATION SCHEME - 500 UNITS

DRAWING TITLE

SHALLOW SEWER:
OVERALL LAYOUT

DRAWING No. UGU-2009-006-900-S-04	REVISION A
--------------------------------------	---------------

W-01	WATER DRAWINGS
STR-01	STRUCTURES DRAWINGS
S-01	SEWER DRAWINGS

